EXXEL PACIFIC
GENERAL CONTRACTORS

Subcontract Change Order

Distribution
- [ ] One Way Plumbing LLC
- [ ] Office
- [ ] Field

Project: 201602. The Cora Apartments (19 W Harrison)
19 W Harrison
Seattle, WA 98109

Change Order #: 3
Change Order Date: 1/31/17
Subcontract #: 201602ONELLC

To (Subcontractor): One Way Plumbing LLC
127 10TH St So., Ste 200
Kirkland, WA 98033

You are directed to make the following changes in this SubContract:

PCO	ACO	Description	Phase	Amount
41	ICO #13	Plumbing Systems	L1.220000.	7,881.00

One Way - Added Exterior Trench Drains on 1st Ave

One Way Plumbing, LLC - Added Exterior Trench Drains on 1st Ave.
Reference COR 07 - Install (4) trench drains along 1st Ave. W, as highlighted attached, NDS DS-090N trench drains and DS-226 stainless steel grates per attached submittal. All mainline storm piping is by others. Trenching/excavation is excluded. Fine grading included.
Total Added: $7,881.00 ($6,853.00 + 15% OH&P)

Total	**7,881.00**

Not valid until signed by both the Subcontractor and Contractor. Signature of the Subcontractor indicates the Subcontractor's agreement herewith, including any adjustment in the Subcontract Sum or Time.

The original Subcontract Sum was	**1,179,300.00**
The net change by previously authorized Change Orders was	**5,090.00**
The Subcontract Sum prior to this Change Order was	**1,184,390.00**
The Subcontract Sum will be increased by this Change Order	**7,881.00**
The new Subcontract Sum will be	**1,192,271.00**

Authorized By Contractor:
Exxel Pacific, Inc.
323 Telegraph Road
Bellingham WA 98226
By: _____
Date: 01·31·17

Accepted By Subcontractor:
One Way Plumbing LLC
127 10TH St So., Ste 200
Kirkland, WA 98033
By: _____
Date: 1/31/2017

PCO #41

ONE WAY PLUMBING, LLC

Change Order Request

January 27, 2017

Exxel Pacific
4220 Aurora Avenue N.
Seattle, WA 98103
Attn: Victor Vo

Re: Cora Apartments – Change Order Request #7 Exterior Trench Drains on 1st Ave

Victor,

Total cost to install the 4ea trench drains along 1st Avenue West, as highlighted attached, is $$6,853 + 15% OH&P = $7,881. We plan to use NDS DS-090N trench drains and DS-226 stainless steel grates per attached submittal. All mainline storm piping is by others. We will hook up to storm via tee left by others. Trenching/excavation is excluded. We will fine grade only.

Please issue an official Change Order at your earliest convenience. Let me know if you have any questions or require further information. Thank you.

Sincerely,

Richard Donelson
Project Manager / Estimator
richd@owpllc.net
425-591-4296 cell

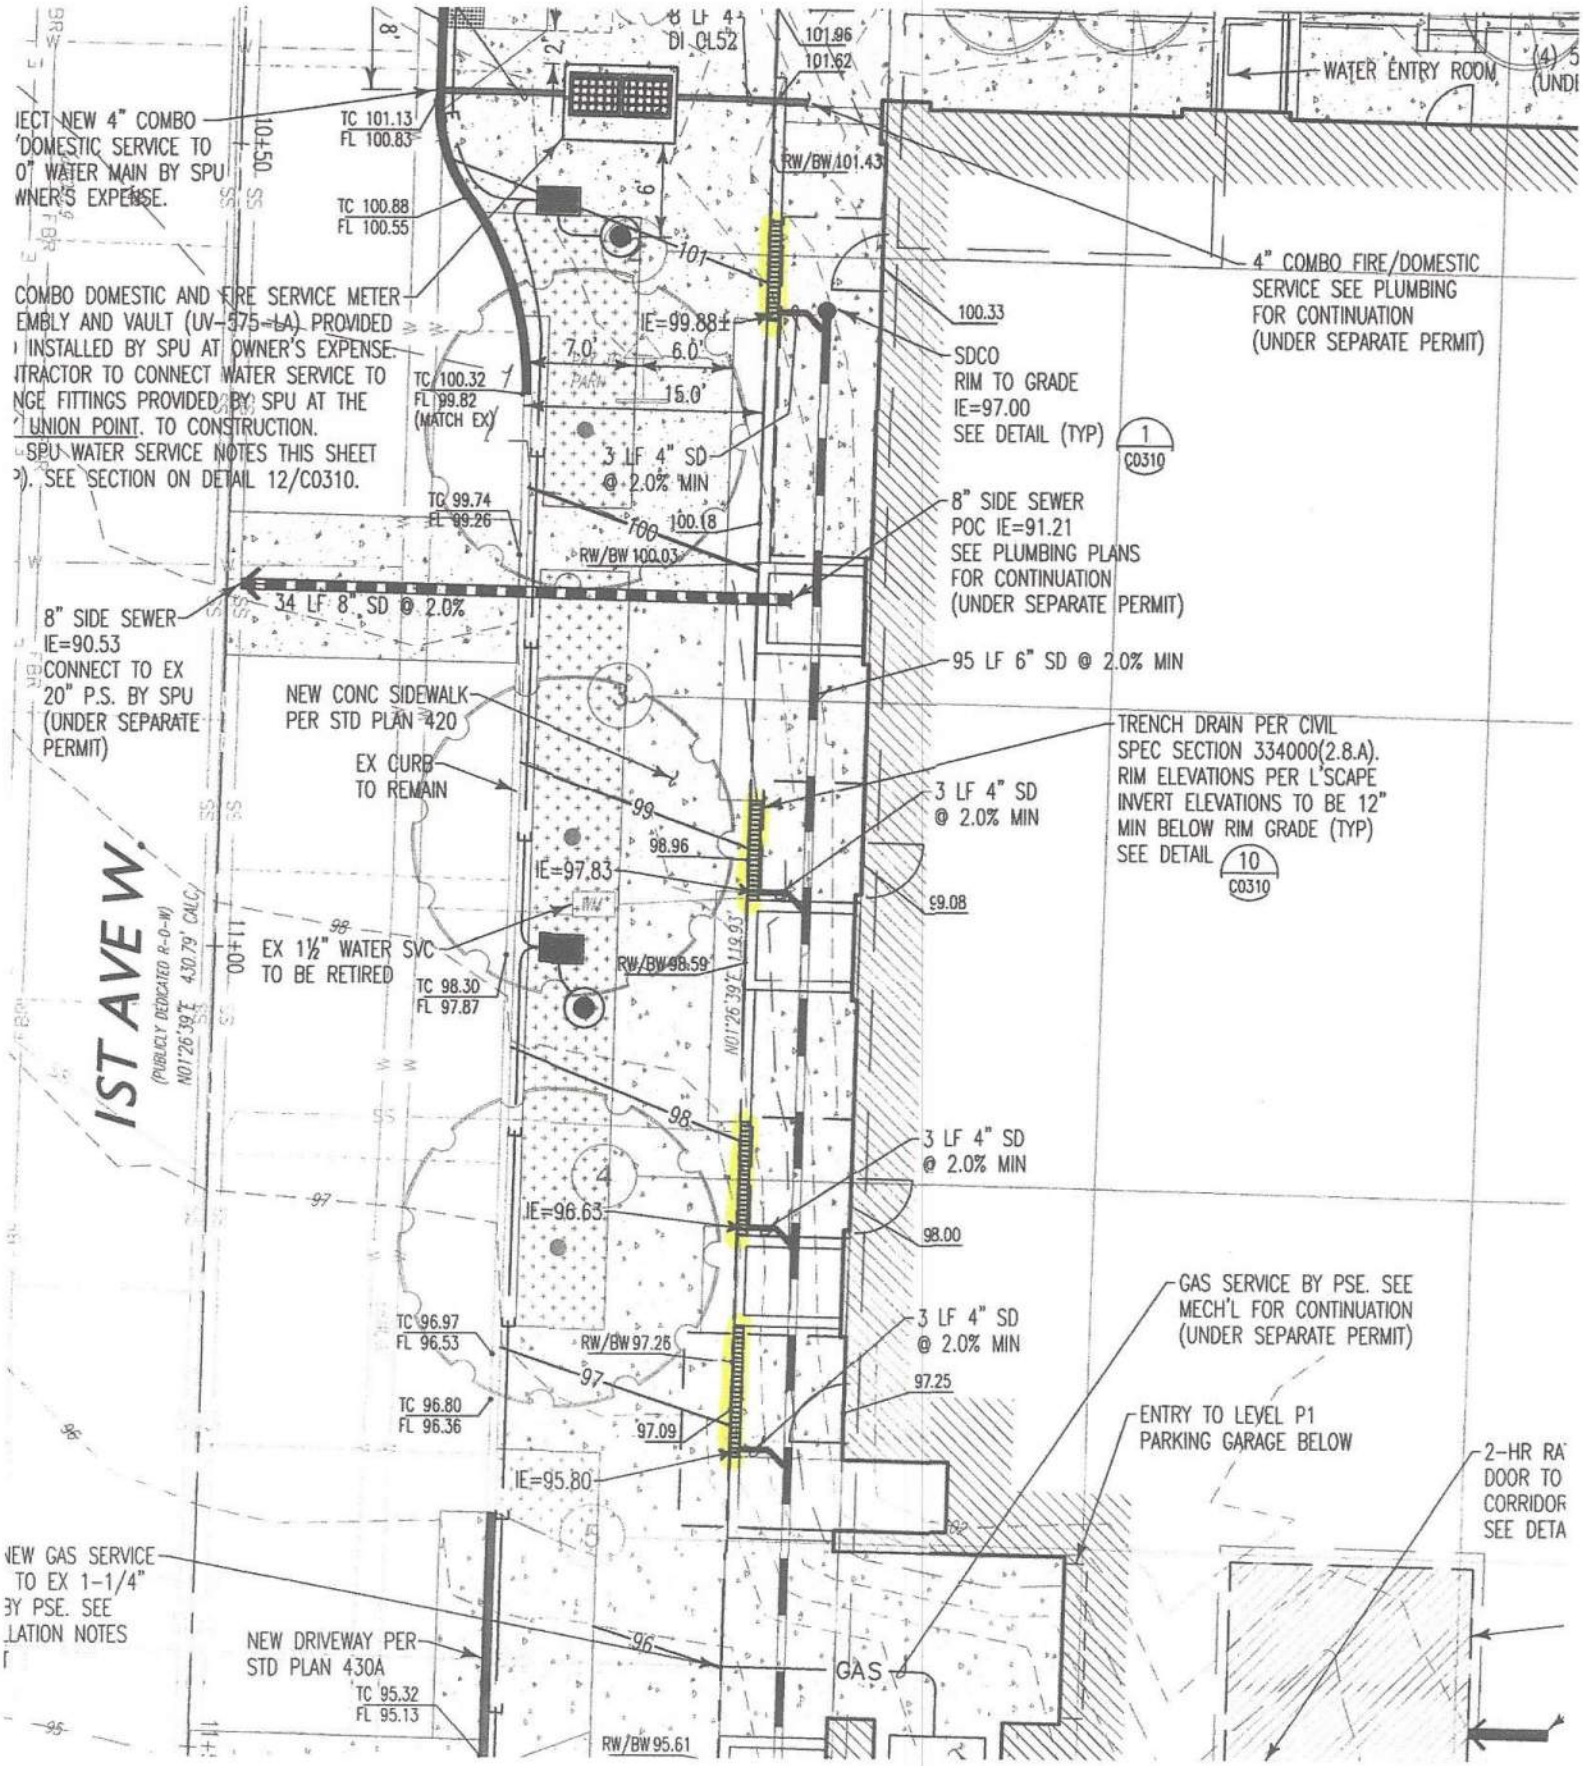
IECT NEW 4" COMBO
'DOMESTIC SERVICE TO
0" WATER MAIN BY SPU
WNER'S EXPENSE.
TC 101.13
FL 100.83
TC 100.88
FL 100.55
COMBO DOMESTIC AND FIRE SERVICE METER
EMBLY AND VAULT (UV-575-LA) PROVIDED
INSTALLED BY SPU AT OWNER'S EXPENSE.
ITRACTOR TO CONNECT WATER SERVICE TO
NGE FITTINGS PROVIDED BY SPU AT THE
UNION POINT. TO CONSTRUCTION.
SPU WATER SERVICE NOTES THIS SHEET
). SEE SECTION ON DETAIL 12/C0310.
8 LF 4"
DI CL52
101.96
101.62
RW/BW 101.43
WATER ENTRY ROOM
4" COMBO FIRE/DOMESTIC
SERVICE SEE PLUMBING
FOR CONTINUATION
(UNDER SEPARATE PERMIT)
IE=99.88±
100.33
SDCO
RIM TO GRADE
IE=97.00
SEE DETAIL (TYP)
1
C0310
TC 100.32
FL 99.82
(MATCH EX)
3 LF 4" SD
@ 2.0% MIN
TC 99.74
FL 99.26
100.18
RW/BW 100.03
8" SIDE SEWER
POC IE=91.21
SEE PLUMBING PLANS
FOR CONTINUATION
(UNDER SEPARATE PERMIT)
34 LF 8" SD @ 2.0%
8" SIDE SEWER
IE=90.53
CONNECT TO EX
20" P.S. BY SPU
(UNDER SEPARATE
PERMIT)
95 LF 6" SD @ 2.0% MIN
NEW CONC SIDEWALK
PER STD PLAN 420
EX CURB
TO REMAIN
TRENCH DRAIN PER CIVIL
SPEC SECTION 334000(2.8.A).
RIM ELEVATIONS PER L'SCAPE
INVERT ELEVATIONS TO BE 12"
MIN BELOW RIM GRADE (TYP)
SEE DETAIL
10
C0310
3 LF 4" SD
@ 2.0% MIN
98.96
IE=97.83
99.08
EX 1½" WATER SVC
TO BE RETIRED
TC 98.30
FL 97.87
RW/BW 98.59
N01°26'39"E 119.93'
IST AVE W.
(PUBLICLY DEDICATED R-O-W)
N01°26'39"E 430.79' CALC.
3 LF 4" SD
@ 2.0% MIN
IE=96.63
98.00
GAS SERVICE BY PSE. SEE
MECH'L FOR CONTINUATION
(UNDER SEPARATE PERMIT)
TC 96.97
FL 96.53
RW/BW 97.26
3 LF 4" SD
@ 2.0% MIN
97.25
TC 96.80
FL 96.36
97.09
ENTRY TO LEVEL P1
PARKING GARAGE BELOW
IE=95.80
2-HR RA
DOOR TO
CORRIDOR
SEE DETA
NEW GAS SERVICE
TO EX 1-1/4"
BY PSE. SEE
LATION NOTES
NEW DRIVEWAY PER
STD PLAN 430A
GAS
TC 95.32
FL 95.13
RW/BW 95.61